





1 Front Stair Pictures - As Built

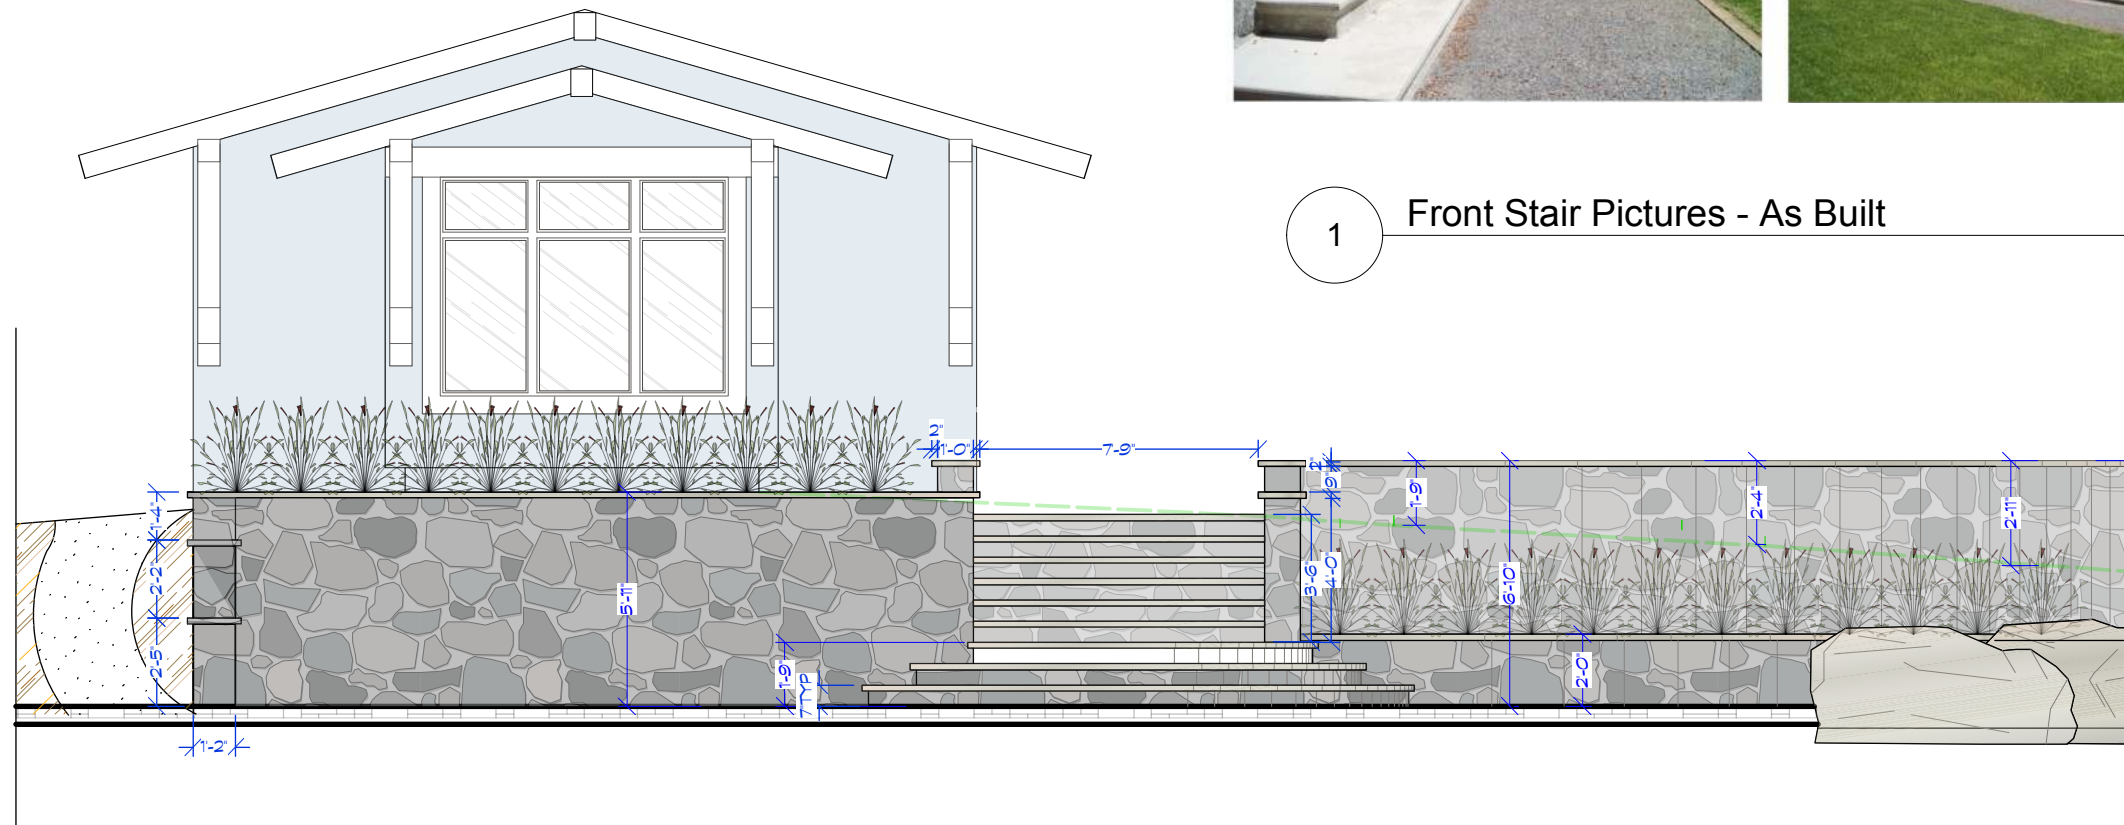

2 Front Stair Elevation - As Built  
Scale: 3/16" = 1'-0"

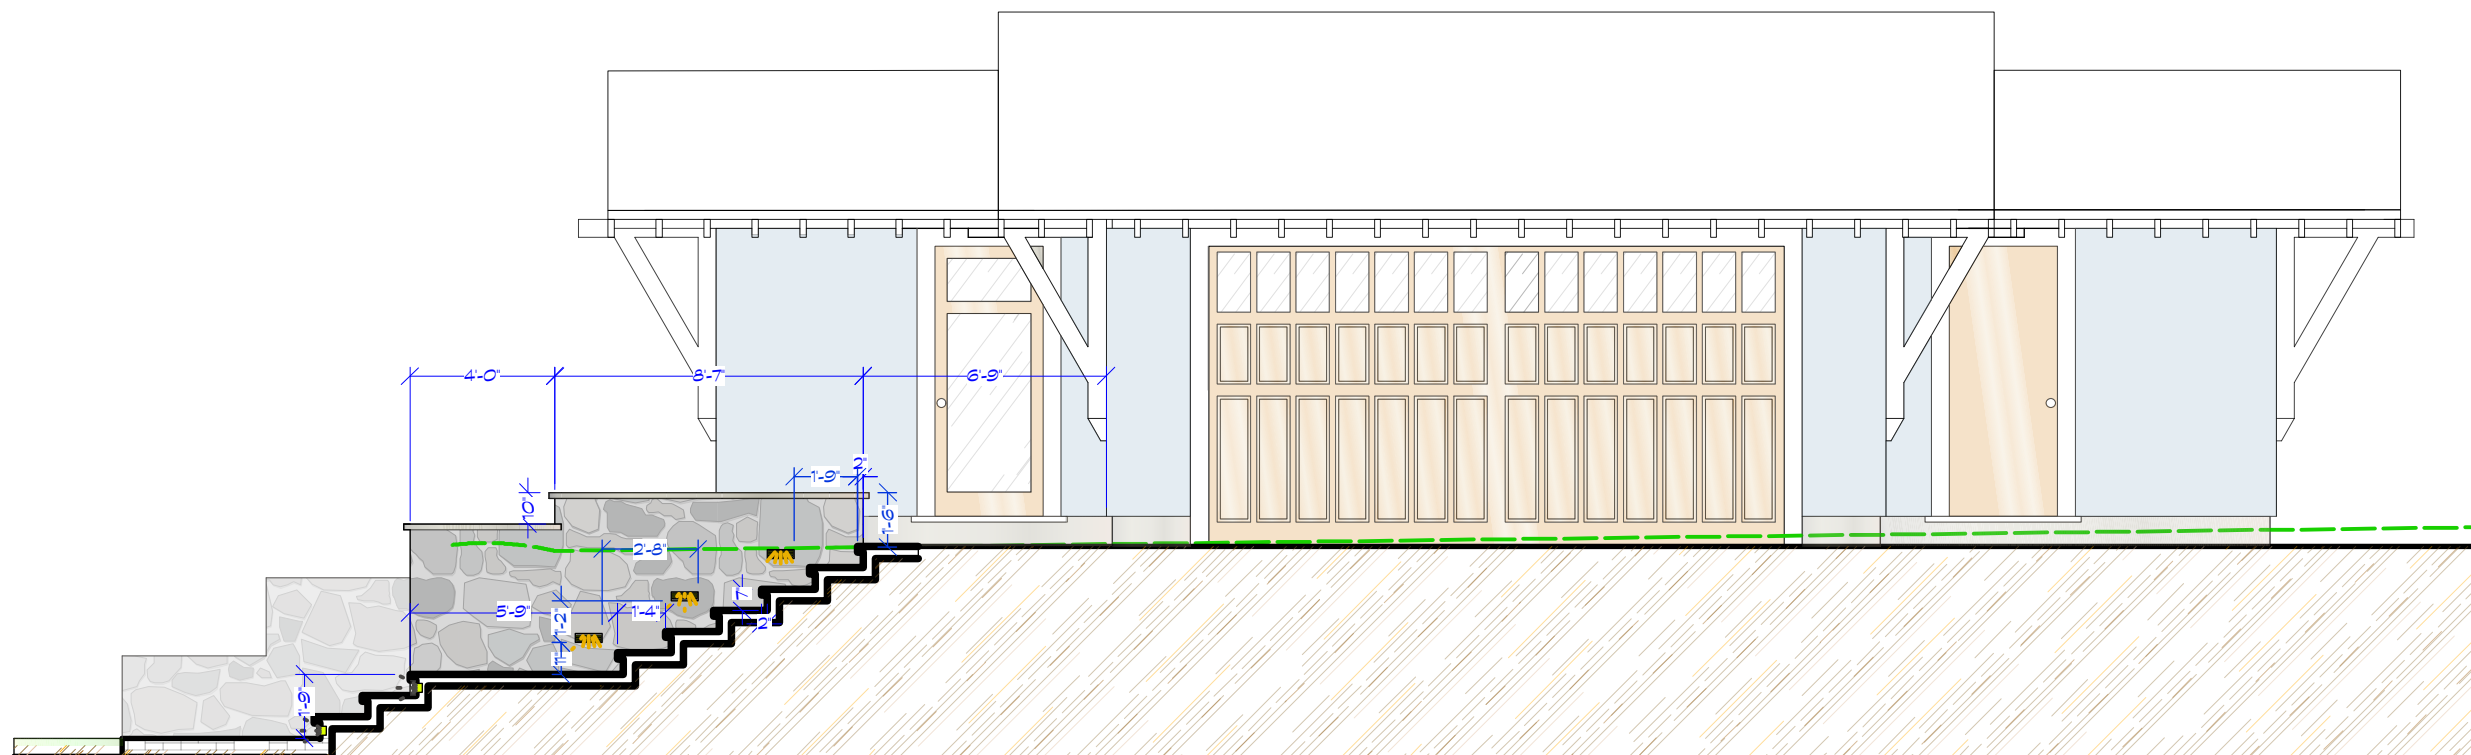

3 Front Stair Section - As Built  
Scale: 3/16" = 1'-0"

Revisions

The design is not to be used or copied without the written consent of Acacia Landscape Inc. All dimensions are in feet and inches. Report any discrepancies to Landscape Architect prior to proceeding with work.

**SOBKIN RESIDENCE**

2828 Seaview  
Victoria, BC

Front Garden - Stair



P.O. Box 5299,  
1625 Fort Street.  
Victoria, B.C.  
V8R 1H9

Tel. 250-595-0527  
Fax. 250-479-2575

Date:  
08/20/2013

**W2**